
THIS DOCUMENT AND ITS CONTENTS ARE THE EXCLUSIVE PROPERTY OF TROY CHEMICAL CO. AND MUST NOT BE COPIED, REPRODUCED, TRANSMITTED OR COMMUNICATED WITHOUT PRIOR WRITTEN APPROVAL OF TROY CHEMICAL CO. THESE PLANS ARE NOT MADE FOR CONSTRUCTION OR INSTALLATION UNLESS USE FOR THIS PURPOSE HAS BEEN EXPRESSLY APPROVED BY TROY CHEMICAL CO.

CONFIDENTIAL

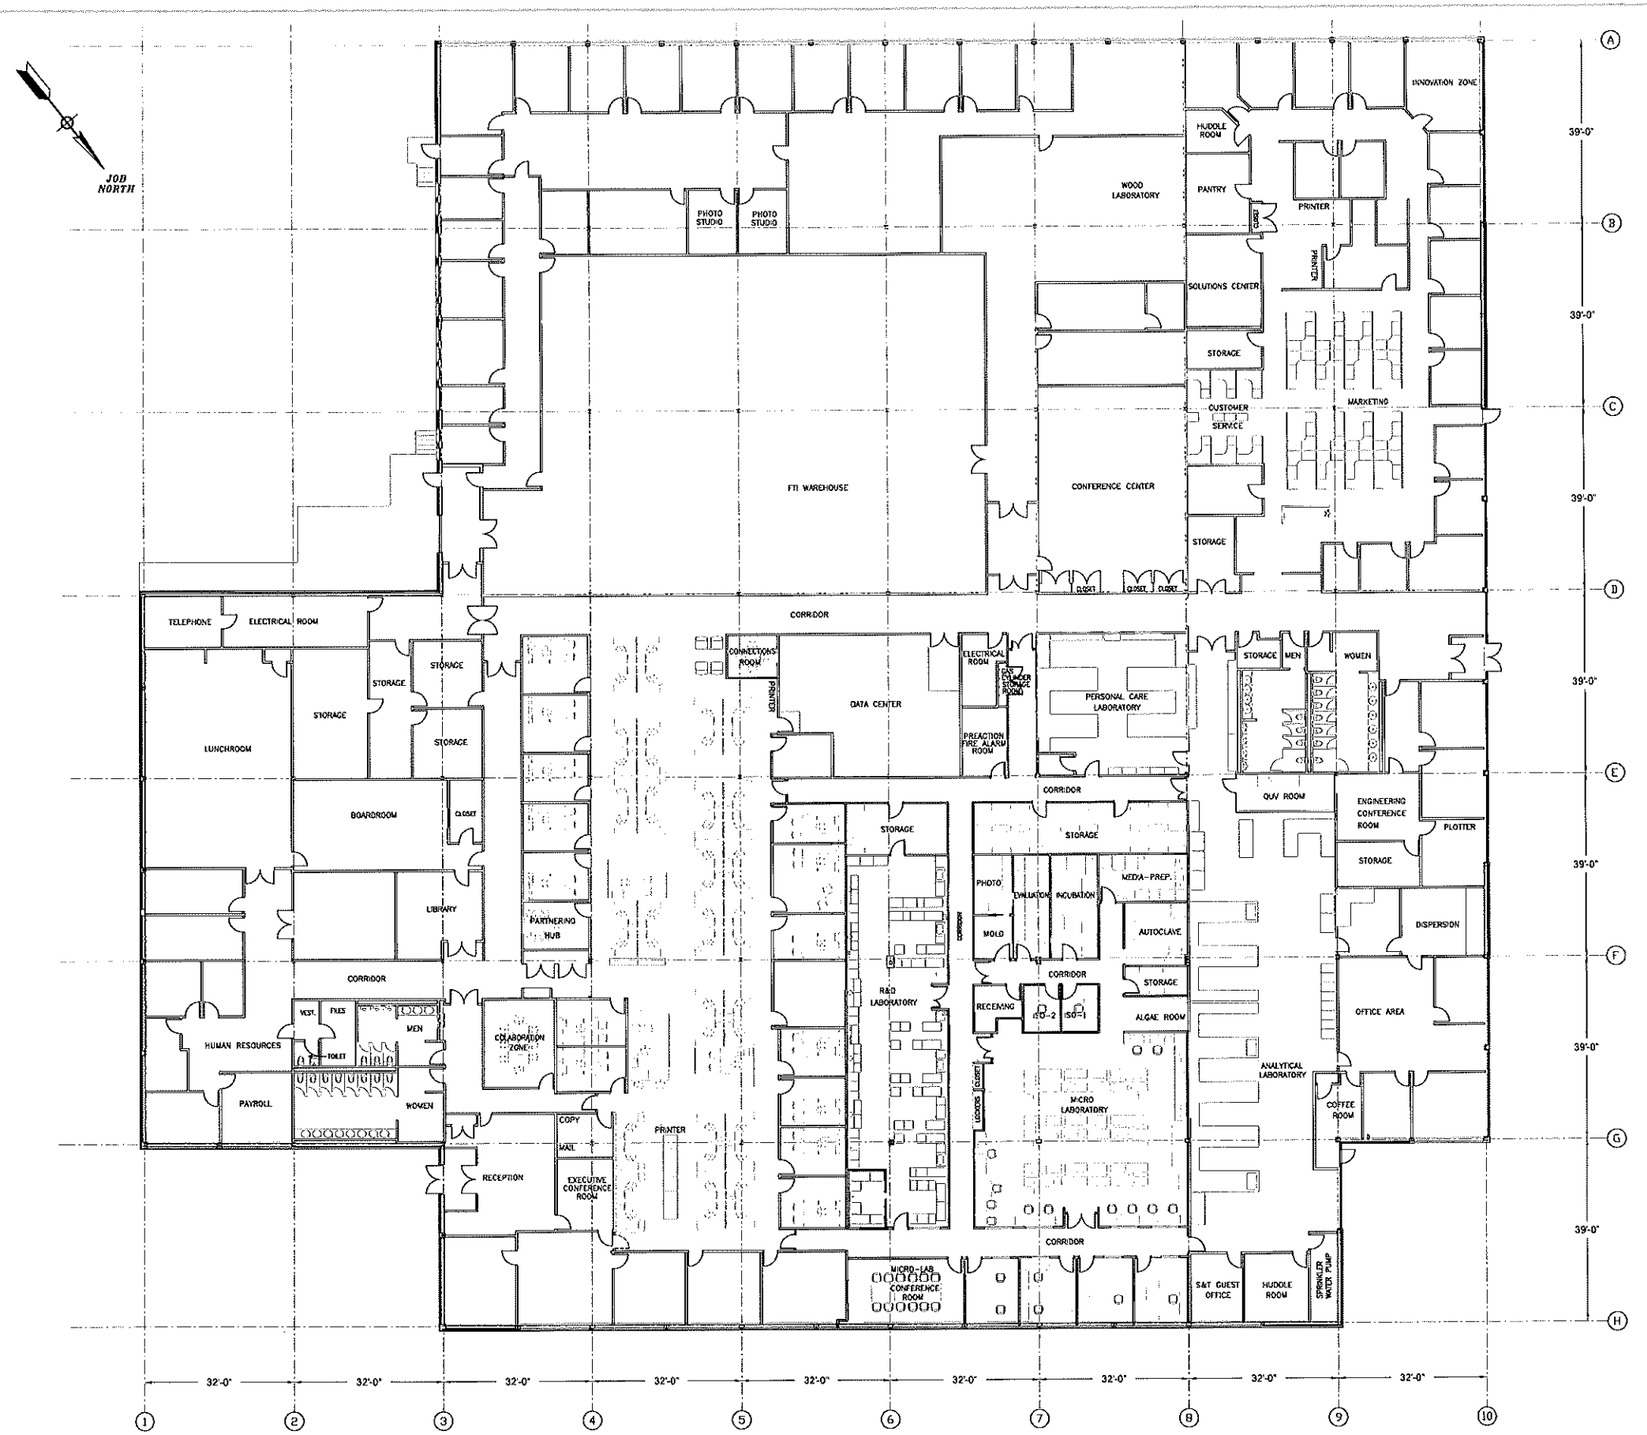


PLAN VIEW

| Rev. | Description | Date | Rev. By | Checked By |
|---|---|---|---|---|
| E | FINANCING & IT RENOVATION | 12. 03. 19 | T. I. | V. D. |
| D | CUSTOMER SERVICE & HALLWAY REMOVATION | 11. 10. 18 | T. I. | V. D. |
| C | R&D LABORATORY ADDED | 06. 06. 17 | T. I. | V. D. |
| B | OFFICE 104 DIMENSION UPDATE | 07. 06. 16 | T. I. | V. D. |
| A | ENGINEERING RELEASE | 03. 17. 16 | T. I. | V. D. |

FLORHAM PARK, NJ
8 VREELAND ROAD
LAYOUT

Drawn By: T. I.
Checked By: V. D.
Approved By: V. D.

No. of Sheets: 1
Sheet No.: 1 OF 1
File: 8
Scale: 1/8" = 1'-0"
Date: 03/17/2016

arxada
TROY CORPORATION
FLORHAM PARK, NJ 07932
Project No.
Drawing No.: FP-LA-08-07
Rev.: E

FILE LOCATION: N:\Troy Florham Park\Building 8